


**Informal Consultation
New & Amended Parking Restrictions
Bancroft Road, Wrotham**

Please return this form to;

The Parking Team
Tonbridge & Malling Borough Council
Gibson Building, Gibson Drive
Kings Hill
West Malling
Kent ME19 4LZ

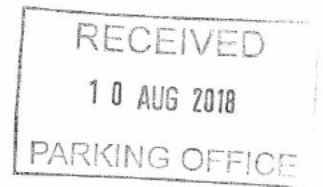

Alternatively, responses can be sent via email to parking.office@tmbc.gov.uk, quoting reference

All responses must be received by 2nd September 2018.

Data protection

Please remember that any comments made may be used within reports to Councillors and within documents that may be made available to the public, though any personal information will be protected.


If you would like more information about how we use your data, please read our Privacy Statement on our website www.tmbc.gov.uk/parking

Name <i>(please print)</i>		
Address		
Telephone		
Email		

I am (in favour / ~~not in favour~~)* of the Borough Council's proposals for changes to the on-street parking arrangements for Bancroft Road, Wrotham, shown on plan DD/583/17

* *delete where not applicable*

Comments	
<p>As a car user, I have problems with residents cars parking on the corner of Bancroft Road, and opposite. Junction of West Street. A blind spot is created, causing drivers to edge out into the main road to check on-coming traffic. yellow lines a very good idea. Thank ya.</p>	
Signed	Date 9.8.18

 

Victoria Sargent


From: [REDACTED]
Sent: 02 September 2018 23:21
To: Parking Office
Subject: Consultation plan ref DD/583/17
Attachments: Ref DD 583 17 (B).jpg; Ref DD 583 17 (A).jpg

Dear Sirs,

Please find attached my response to your letter dated 03/08/18, your ref 'Phase 10-inf-DD/583/17'.

Regards,


[REDACTED]

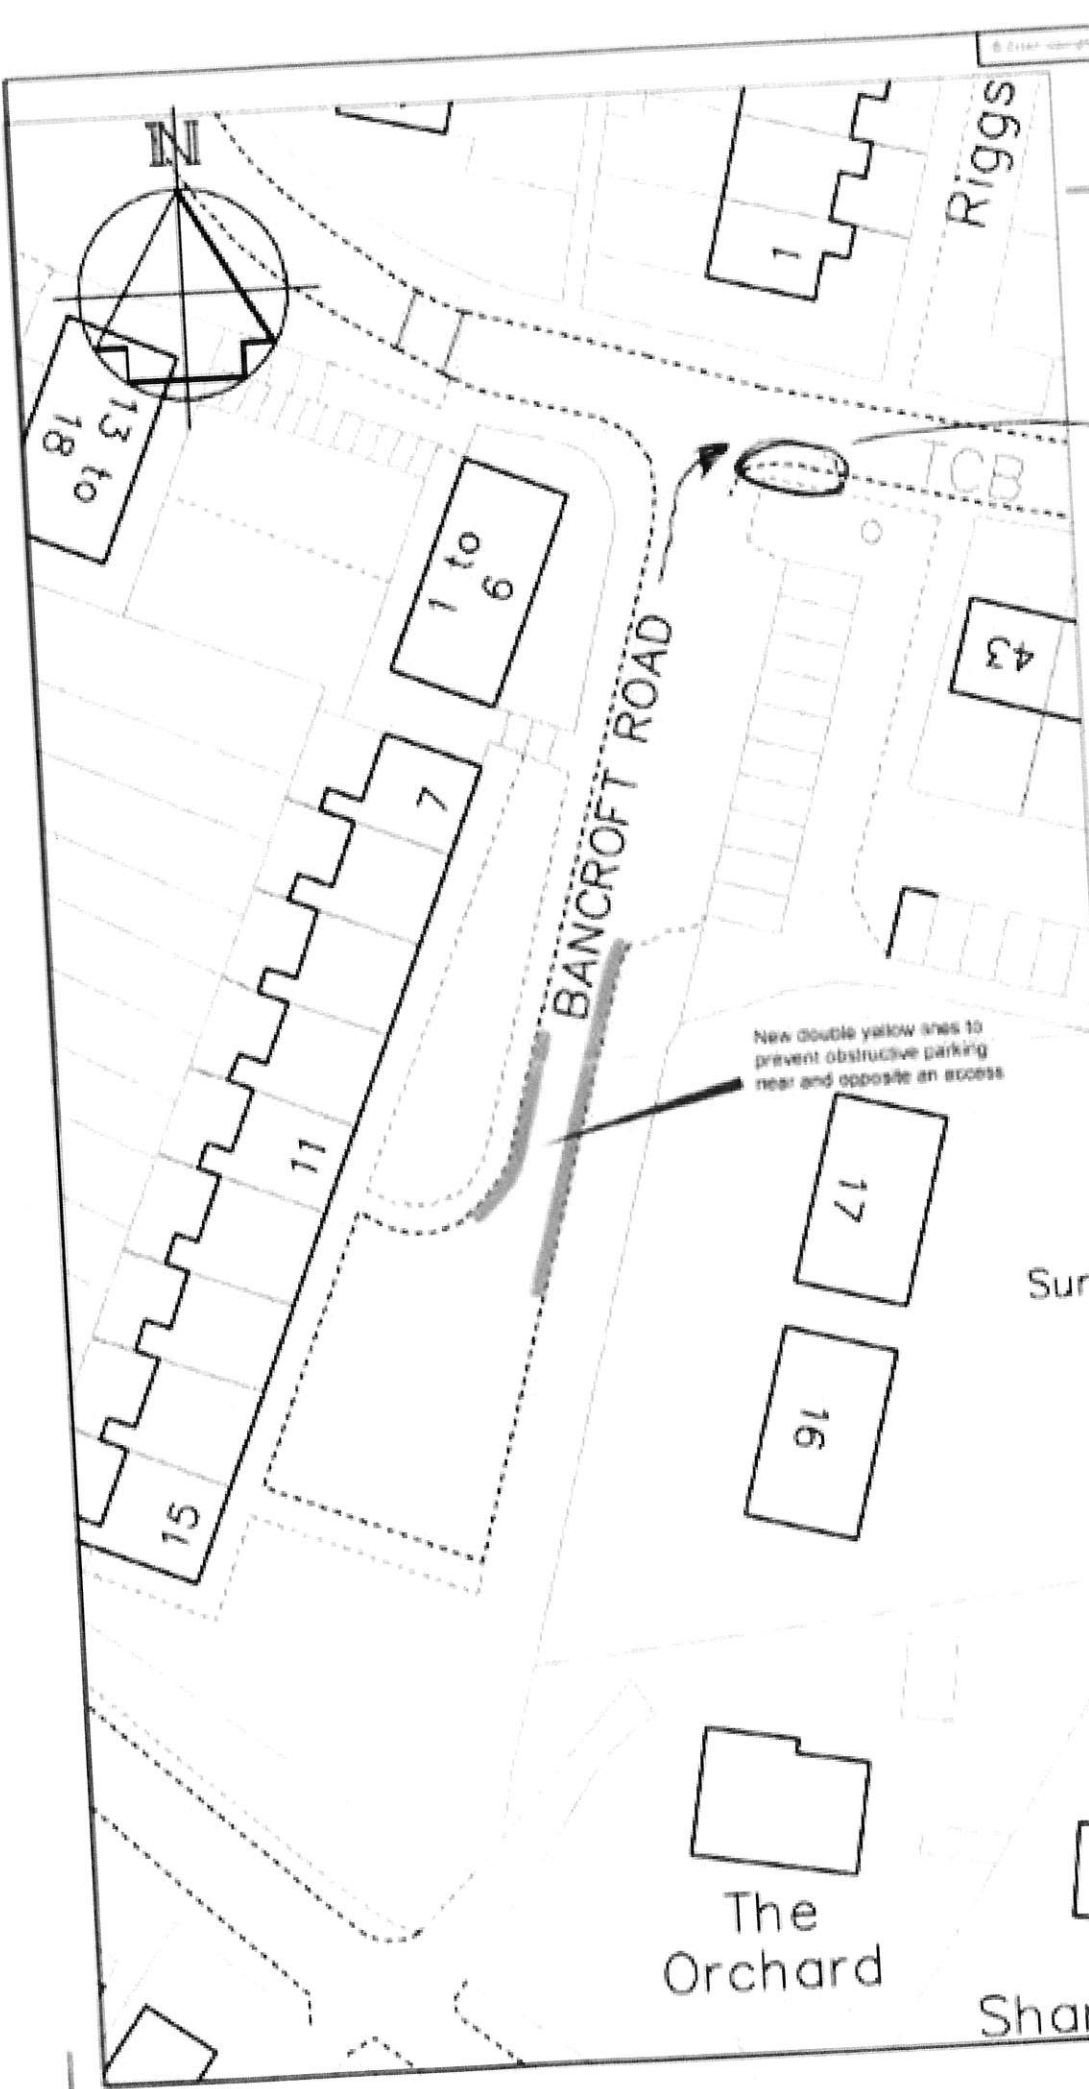

Key
 — Proposed "No waiting at any time" (double yellow lines)

Parking right to the corner obstructs visibility of oncoming traffic

New double yellow lines to prevent obstructive parking near and opposite an access

Revision	Date
 TONBRIDGE & MALLING <small>borough council</small> STREETSCAPE, LEISURE & TECHNICAL SERVICES	
Transportation Team Gibson Building Gibson Drive Kings Hill West Malling Kent ME19 4LZ Tel: 01732 844522 Fax: 01732 816017	
Project Title Local Parking Plan - Phase 10 Informal consultation	
Drawing Title Wrotham Bancroft Road	
Drawn A/CB	Checked A/Y
Date: 8/2018	
Scale: 1 : 500 @ A4	
Drawing No. DD/583/17	Rev

Sharn

**Informal Consultation
New & Amended Parking Restrictions
Bancroft Road, Wrotham**

Please return this form to:

The Parking Team
Tonbridge & Malling Borough Council
Gibson Building, Gibson Drive
Kings Hill
West Malling
Kent ME19 4LZ

Alternatively, responses can be sent via email to parking_office@tmbc.gov.uk, quoting reference

All responses must be received by 2nd September 2018.

Data protection

Please remember that any comments made may be used within reports to Councillors and within documents that may be made available to the public, though any personal information will be protected.

If you would like more information about how we use your data, please read our Privacy Statement on our website www.tmbc.gov.uk/parking

Name (please print)	[Redacted]	
Address	[Redacted]	7BE
Telephone	[Redacted]	
Email	[Redacted]	

I am (in favour / ~~not in favour~~)* of the Borough Council's proposals for changes to the on-street parking arrangements for Bancroft Road, Wrotham, shown on plan DD/583/17

* delete where not applicable

Comments	
<p>whilst it should be obvious that parking outside the entrance of a drive would make it very difficult to enter/exit the property it is a regular nuisance to us. I would also highlight that parking in the top right-hand corner of Bancroft Rd/West St means it is impossible to see oncoming traffic when trying to exit Bancroft Rd, which is very likely to lead to an accident at some point.</p>	
Signed	Date 2/9/18

**Informal Consultation
New & Amended Parking Restrictions
Bancroft Road, Wrotham**

Please return this form to;

The Parking Team
Tonbridge & Malling Borough Council
Gibson Building, Gibson Drive
Kings Hill
West Malling
Kent ME19 4LZ



Alternatively, responses can be sent via email to parking.office@tmbc.gov.uk, quoting reference

All responses must be received by 2nd September 2018.

Data protection

Please remember that any comments made may be used within reports to Councillors and within documents that may be made available to the public, though any personal information will be protected.

If you would like more information about how we use your data, please read our Privacy Statement on our website www.tmbc.gov.uk/parking

Name (please print)	[REDACTED]
Address	[REDACTED] 7BE
Telephone	[REDACTED]
Email	[REDACTED]

I am **(in favour / ~~not in favour~~)*** of the Borough Council's proposals for changes to the on-street parking arrangements for Bancroft Road, Wrotham, shown on plan DD/583/17

* *delete where not applicable*

Comments	
<p>Dear Sirs</p> <p>I wonder if it is possible to look at entry to Bancroft it is hard to get round the Top at times sorry to be greedy</p>	
Signed	[REDACTED]
Date	14-8-18



Claire Twinn

From: [REDACTED]
Sent: 20 August 2018 17:10
To: Parking Office
Subject: Re: Yellow lines bancroft road
Attachments: __attachment_message__1534781023471.eml

Sent from my Samsung device

Claire Twinn

From: [REDACTED]
Sent: 20 August 2018 14:15
To: parking.office@tnbc.gov.uk
Subject: Yellow lines bancroft road

20/8/18

I am in favour of the yellow lines being put in place , please also take into consideration the occupant at [REDACTED] [REDACTED] has a disabled bay which is not shown on the diagram , also I feel that yellow lines should be put at the end of bancroft road adjacent to west Street as people are constantly parking on the corner and I have experienced many near misses having to pull out around vehicles.


Many thanks

[REDACTED]

**Informal Consultation
New & Amended Parking Restrictions
Bancroft Road, Wrotham**

Please return this form to;

The Parking Team
Tonbridge & Malling Borough Council
Gibson Building, Gibson Drive
Kings Hill
West Malling
Kent ME19 4LZ

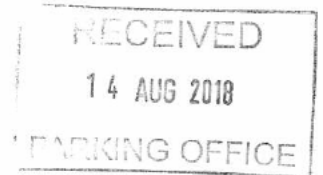

Alternatively, responses can be sent via email to parking.office@tmbc.gov.uk, quoting reference

All responses must be received by 2nd September 2018.

Data protection

Please remember that any comments made may be used within reports to Councillors and within documents that may be made available to the public, though any personal information will be protected.

If you would like more information about how we use your data, please read our Privacy Statement on our website www.tmbc.gov.uk/parking

Name (please print)	[Redacted]
Address	[Redacted]
Telephone	[Redacted]
Email	[Redacted]

I am **(in favour / ~~not in favour~~)*** of the Borough Council's proposals for changes to the on-street parking arrangements for Bancroft Road, Wrotham, shown on plan DD/583/17

*** delete where not applicable**

Comments	
<p>There are sufficient parking spaces in the cul-de-sac and opposite the garages for anyone visiting Bancroft Road. The proposed yellow lines are only a small section of the road which will be a great advantage to anyone visiting me as access will then be available. The parking has deteriorated over the past few years.</p>	
Signed	Date
[Redacted]	8/4/18