

**Informal Consultation
New & Amended Parking Restrictions
Dodd Road & Romney Way, Tonbridge**

Please return this form to;

The Parking Team
Tonbridge & Malling Borough Council
Gibson Building, Gibson Drive
Kings Hill
West Malling
Kent ME19 4LZ

Alternatively, responses can be sent via email to parking.office@tmbc.gov.uk, quoting reference DD/591/20 Dodd Road & Romney Way

Want to go digital? You can view the proposals and respond online by visiting www.tmbc.gov.uk/parkingphases or scanning this QR code



All responses must be received by 30th January 2022.

Data protection

Please remember that any comments made may be used within reports to Councillors and within documents that may be made available to the public, though any personal information will be protected.

If you would like more information about how we use your data, please read our Privacy Statement on our website www.tmbc.gov.uk/parking

Name (please print)	
Address	
Telephone	
Email	

I am (in favour / ~~not in favour~~)* of the Borough Council's proposals for changes to the on-street parking arrangements for Dodd Road & Romney Way, , shown on plan DD/591/20

* delete where not applicable


however,

Comments	
<p>✓ parking should not be allowed opposite the 'T'-junction either and Residents should not park vans along this part of Romney way - It is a bus route,</p>	
Signed	Date 10/1/22.

the vans cause lack of vision or block traffic or parked on kerb restrict prams and wheelchair users. (see amended map).

Key

Proposed "No waiting at any time" (double yellow lines)

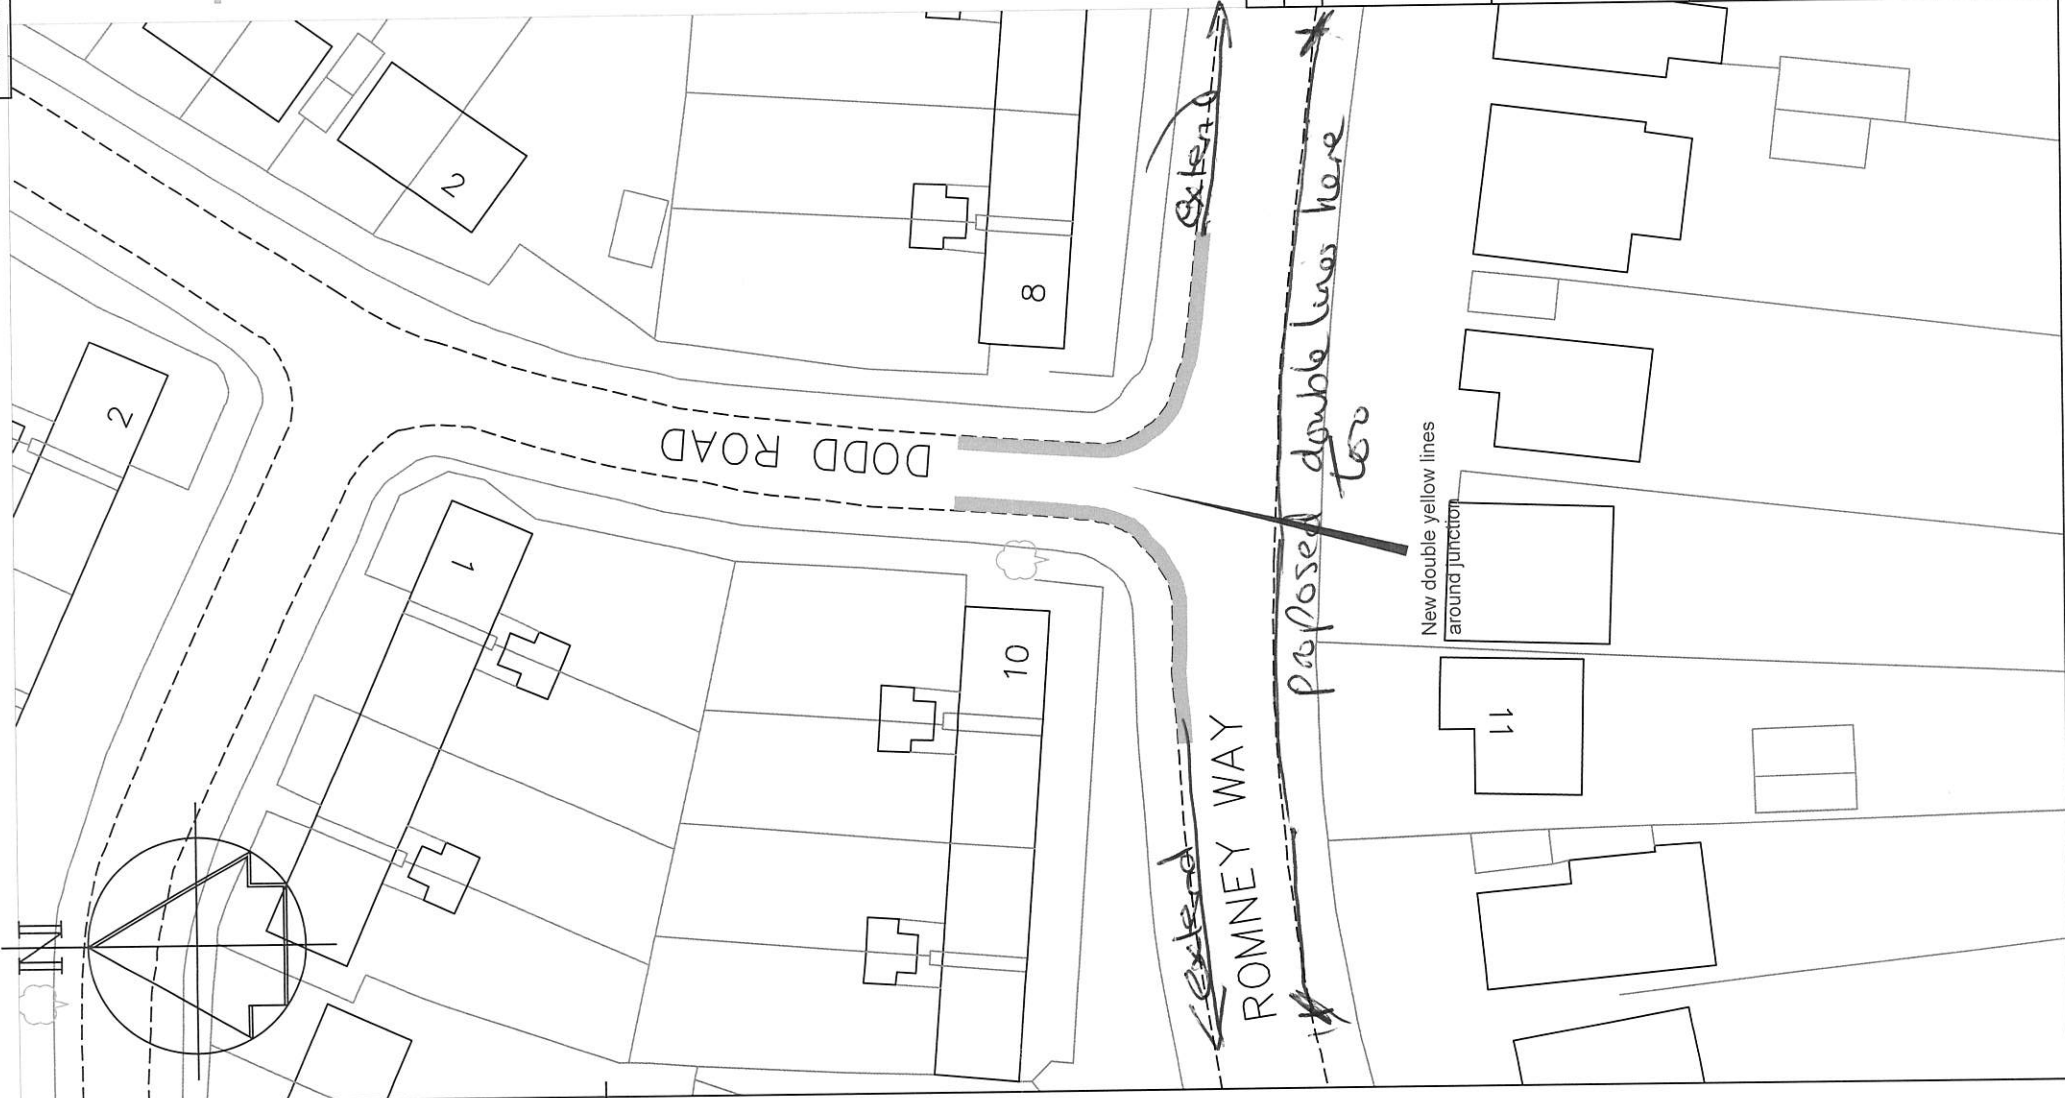

Revision	Date
-	-



Technical Services
 Gibson Building
 Gibson Drive
 Kings Hill
 West Malling
 Kent ME19 4LZ
 Tel: 01732 844622 Fax: 01732 876317

Project Title
Parking Action Plan
Phase 13
 Informal consultation

Drawing Title
 Tonbridge
 Dodd Road & Romney Way

Drawn: ACB | Checked: AE | Date: 11/2021

Scale 1 : 500 @ A4

Drawing No.

DD/591/20

Rev

-

**Informal Consultation
New & Amended Parking Restrictions
Dodd Road & Romney Way, Tonbridge**

Please return this form to;

The Parking Team
Tonbridge & Malling Borough Council
Gibson Building, Gibson Drive
Kings Hill
West Malling
Kent ME19 4LZ

Alternatively, responses can be sent via email to parking.office@tmbc.gov.uk, quoting reference DD/591/20 Dodd Road & Romney Way

Want to go digital? You can view the proposals and respond online by visiting www.tmbc.gov.uk/parkingphases or scanning this QR code



All responses must be received by 30th January 2022.

Data protection

Please remember that any comments made may be used within reports to Councillors and within documents that may be made available to the public, though any personal information will be protected.

If you would like more information about how we use your data, please read our Privacy Statement on our website www.tmbc.gov.uk/parking

Name (please print)	[Redacted]
Address	[Redacted]
Telephone	[Redacted]
Email	[Redacted]

I am (in favour / ~~not in favour~~)* of the Borough Council's proposals for changes to the on-street parking arrangements for Dodd Road & Romney Way, , shown on plan DD/591/20

Very good idea

* delete where not applicable

Comments

This corner is very dangerous — people parking there — I walk [Redacted] to the shops regularly and don't have a clear view

Signed [Redacted]

Date *12/1/22*

for crossing the road