

**Informal Consultation
New & Amended Parking Restrictions
Priory Road, Tonbridge**

Please return this form to;

The Parking Team
Tonbridge & Malling Borough Council
Gibson Building, Gibson Drive
Kings Hill
West Malling
Kent ME19 4LZ

Alternatively, responses can be sent via email to parking.office@tmbc.gov.uk, quoting reference DD/591/21 Priory Road

Want to go digital? You can view the proposals and respond online by visiting www.tmbc.gov.uk/parkingphases or scanning this QR code



All responses must be received by 30th January 2022.

Data protection

Please remember that any comments made may be used within reports to Councillors and within documents that may be made available to the public, though any personal information will be protected.

If you would like more information about how we use your data, please read our Privacy Statement on our website www.tmbc.gov.uk/parking

Name <i>(please print)</i>		
Address		
Telephone		
Email		

I am (~~in favour~~ / **not in favour**)* of the Borough Council's proposals for changes to the on-street parking arrangements for Priory Road, , shown on plan DD/591/21

* **delete where not applicable**

Comments	
IF THIS MEANS BUSES WILL BE PARKED IN THE AREA, SOME OF THE BUS DRIVERS LEAVE THERE ENGINES RUNNING WHILE WAITING SO NOISE & POLLUTION HAS TO BE CONSIDERED FOR RESIDENTS MAINLY ELDERLY	
Signed [REDACTED]	Date 10-1-22

**Informal Consultation
New & Amended Parking Restrictions
Priory Road, Tonbridge**

Please return this form to;

The Parking Team
Tonbridge & Malling Borough Council
Gibson Building, Gibson Drive
Kings Hill
West Malling
Kent ME19 4LZ

Alternatively, responses can be sent via email to parking.office@tmbc.gov.uk, quoting reference DD/591/21 Priory Road

Want to go digital? You can view the proposals and respond online by visiting www.tmbc.gov.uk/parkingphases or scanning this QR code



All responses must be received by 30th January 2022.

Data protection

Please remember that any comments made may be used within reports to Councillors and within documents that may be made available to the public, though any personal information will be protected.

If you would like more information about how we use your data, please read our Privacy Statement on our website www.tmbc.gov.uk/parking

Name <i>(please print)</i>	[Redacted]
Address	
Telephone	
Email	

I am ^{conditionally} **(in favour / ~~not in favour~~)*** of the Borough Council's proposals for changes to the on-street parking arrangements for Priory Road, , shown on plan DD/591/21

** delete where not applicable*


Comments	
See attached . with conditions.	
Signed	Date 19/01/2022.

Enclosed:

Consultation plan ref : DD/591/21
Informal consultation response form

In theory I am not against the proposal on condition certain conditions are met.

- 1.) All Busses switch off their engines when stopped at these bus stops. The continual running of the engines causes not only noise pollution but also fumes from the exhausts fill the flats in Becket Court.
- 2.) Cars per examples on DRAWING DD/591/21 continually park on double yellow lines making entry and exit of Alexandra Road both difficult and dangerous. Despite numerous reports to parking attendants not much is improving. Parking illegally in Alexandra Road on double yellow lines means that often the dropped curbs which is used by residents with scooters (mobility) and/or walkers and shopping carts are not able to cross the road safely.

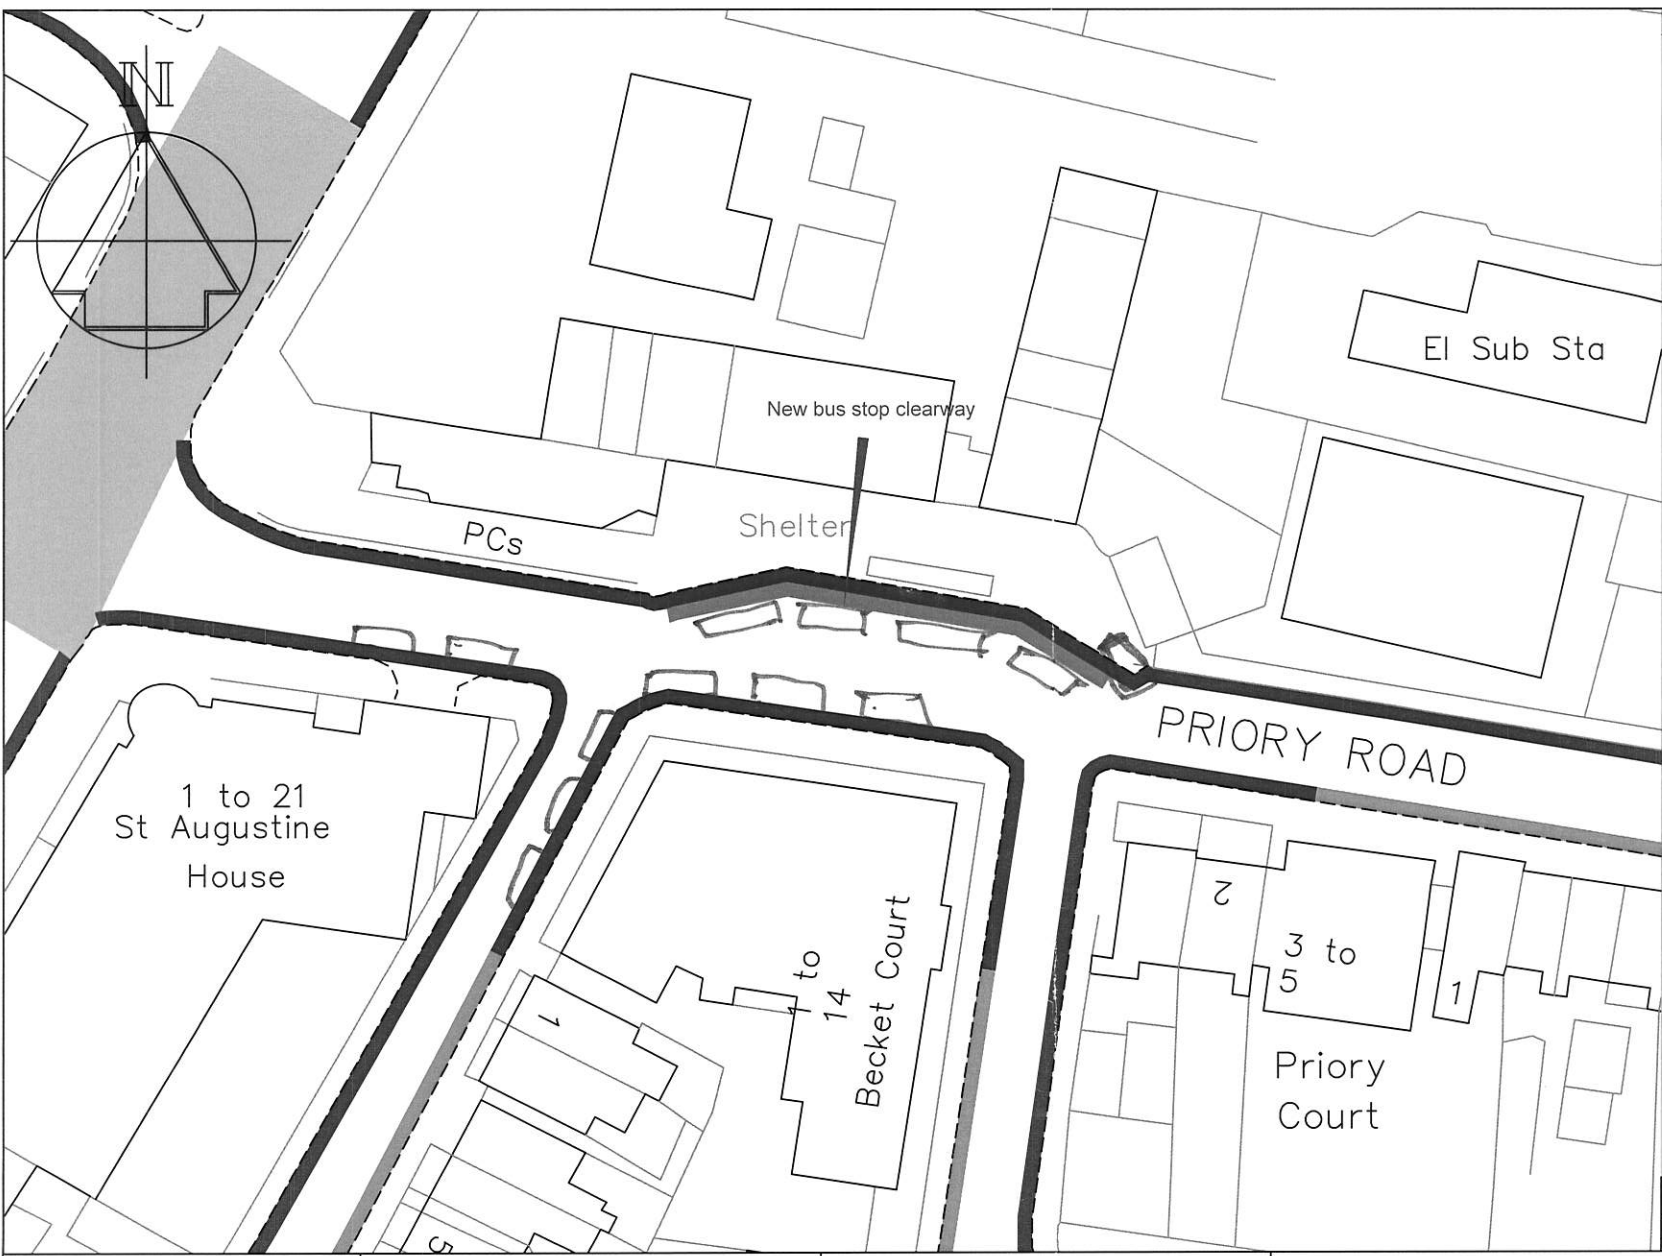

Key

Existing "No waiting at any time" (double yellow lines)

Proposed bus stop clearway

CARS PARKING ON DOUBLE YELLOW LINES WITH NO REPERCUSSIONS.

BUSES THAT SIT WITH ENGINES RUNNING - CAUSING FUMES TO FILL FLATS IN BECKET COURT

-	-	-
Revision		Date



STREETSCENE,
LEISURE &
TECHNICAL SERVICES

Transportation Team
Gibson Building
Gibson Drive
Kings Hill
West Malling
Kent ME19 4LZ
Tel: 01732 844522 Fax: 01732 876317

Project Title
Parking Action Plan - Phase 13
Informal consultation

Drawing Title
Tonbridge
Priory Road

Drawn ACB	Checked AE	Date 12/2021
--------------	---------------	-----------------

Scale 1 : 500 @ A4

Drawing No. DD/591/21	Rev -
--------------------------	----------

**Informal Consultation
New & Amended Parking Restrictions
Priory Road, Tonbridge**

Please return this form to;

The Parking Team
Tonbridge & Malling Borough Council
Gibson Building, Gibson Drive
Kings Hill
West Malling
Kent ME19 4LZ

Alternatively, responses can be sent via email to parking.office@tmbc.gov.uk, quoting reference DD/591/21 Priory Road

Want to go digital? You can view the proposals and respond online by visiting www.tmbc.gov.uk/parkingphases or scanning this QR code



All responses must be received by 30th January 2022.

Data protection

Please remember that any comments made may be used within reports to Councillors and within documents that may be made available to the public, though any personal information will be protected.

If you would like more information about how we use your data, please read our Privacy Statement on our website www.tmbc.gov.uk/parking

Name (please print)		
Address		
Telephone		
Email		

I am (~~in favour~~ / **not in favour**)* of the Borough Council's proposals for changes to the on-street parking arrangements for Priory Road, , shown on plan DD/591/21

* **delete where not applicable**

Comments	
<p><i>I am certainly <u>NOT</u> in favour of <u>MORE</u> buses parked in Priory Road. Every day we have to put up with cars and Buses parked here. I have written to the Council to ask for signs for bus's to turn off their Engines, with no response. This is a terrible POLLUTION HAZARD, also with the cars</i></p>	
Signed	Date
	22/1/2022


P.T.O.

parked outside (directly under my windows) trying to get out of Alexandra Road is another hazard when turning right onto Priory Road you cannot see passed lorries and parked cars, let alone any bus's parked on that corner.

If more bus's are parked in the bus stop pay-by and cars parked opposite, also delivery drivers where can the Taxi drivers park to use the loo?

I am 100% against more parked bus's in Priory Road.

We also have the noise throughout the night of the Railway Workers in their yard.

 

**Informal Consultation
New & Amended Parking Restrictions
Priory Road, Tonbridge**

Please return this form to;

The Parking Team
Tonbridge & Malling Borough Council
Gibson Building, Gibson Drive
Kings Hill
West Malling
Kent ME19 4LZ

Alternatively, responses can be sent via email to parking.office@tmbc.gov.uk, quoting reference DD/591/21 Priory Road

Want to go digital? You can view the proposals and respond online by visiting www.tmbc.gov.uk/parkingphases or scanning this QR code



All responses must be received by 30th January 2022.

Data protection

Please remember that any comments made may be used within reports to Councillors and within documents that may be made available to the public, though any personal information will be protected.

If you would like more information about how we use your data, please read our Privacy Statement on our website www.tmbc.gov.uk/parking

Name <i>(please print)</i>	[Redacted]
Address	[Redacted]
Telephone	[Redacted]
Email	[Redacted]

I am (~~in favour~~ / **not in favour**)* of the Borough Council's proposals for changes to the on-street parking arrangements for Priory Road, , shown on plan DD/591/21

* *delete where not applicable*


Comments	
PTO.	
Sign	Date 11.1.22

I am not in favour of the borough Councils proposals for changes to the on street parking arrangements. The reason being.

I live in Becket Court right opposite where you are going to do these changes.

On many occasions I have tried to get out of Alexandra Road in my car to find buses parked either side and sometimes double parked so you can't see when you pull out to which I have had to do emergency stops as cars they can't see me and I can't see them approaching.

Becket Court is for elderly people with health conditions why do we have to put up with buses revving their engines morning and night fumes coming through windows so have to keep windows shut even in summer they vibrate the whole building and they are antique buses not even new. We moved in here to get a peaceful life why do we have to be disturbed by school buses early in the morning

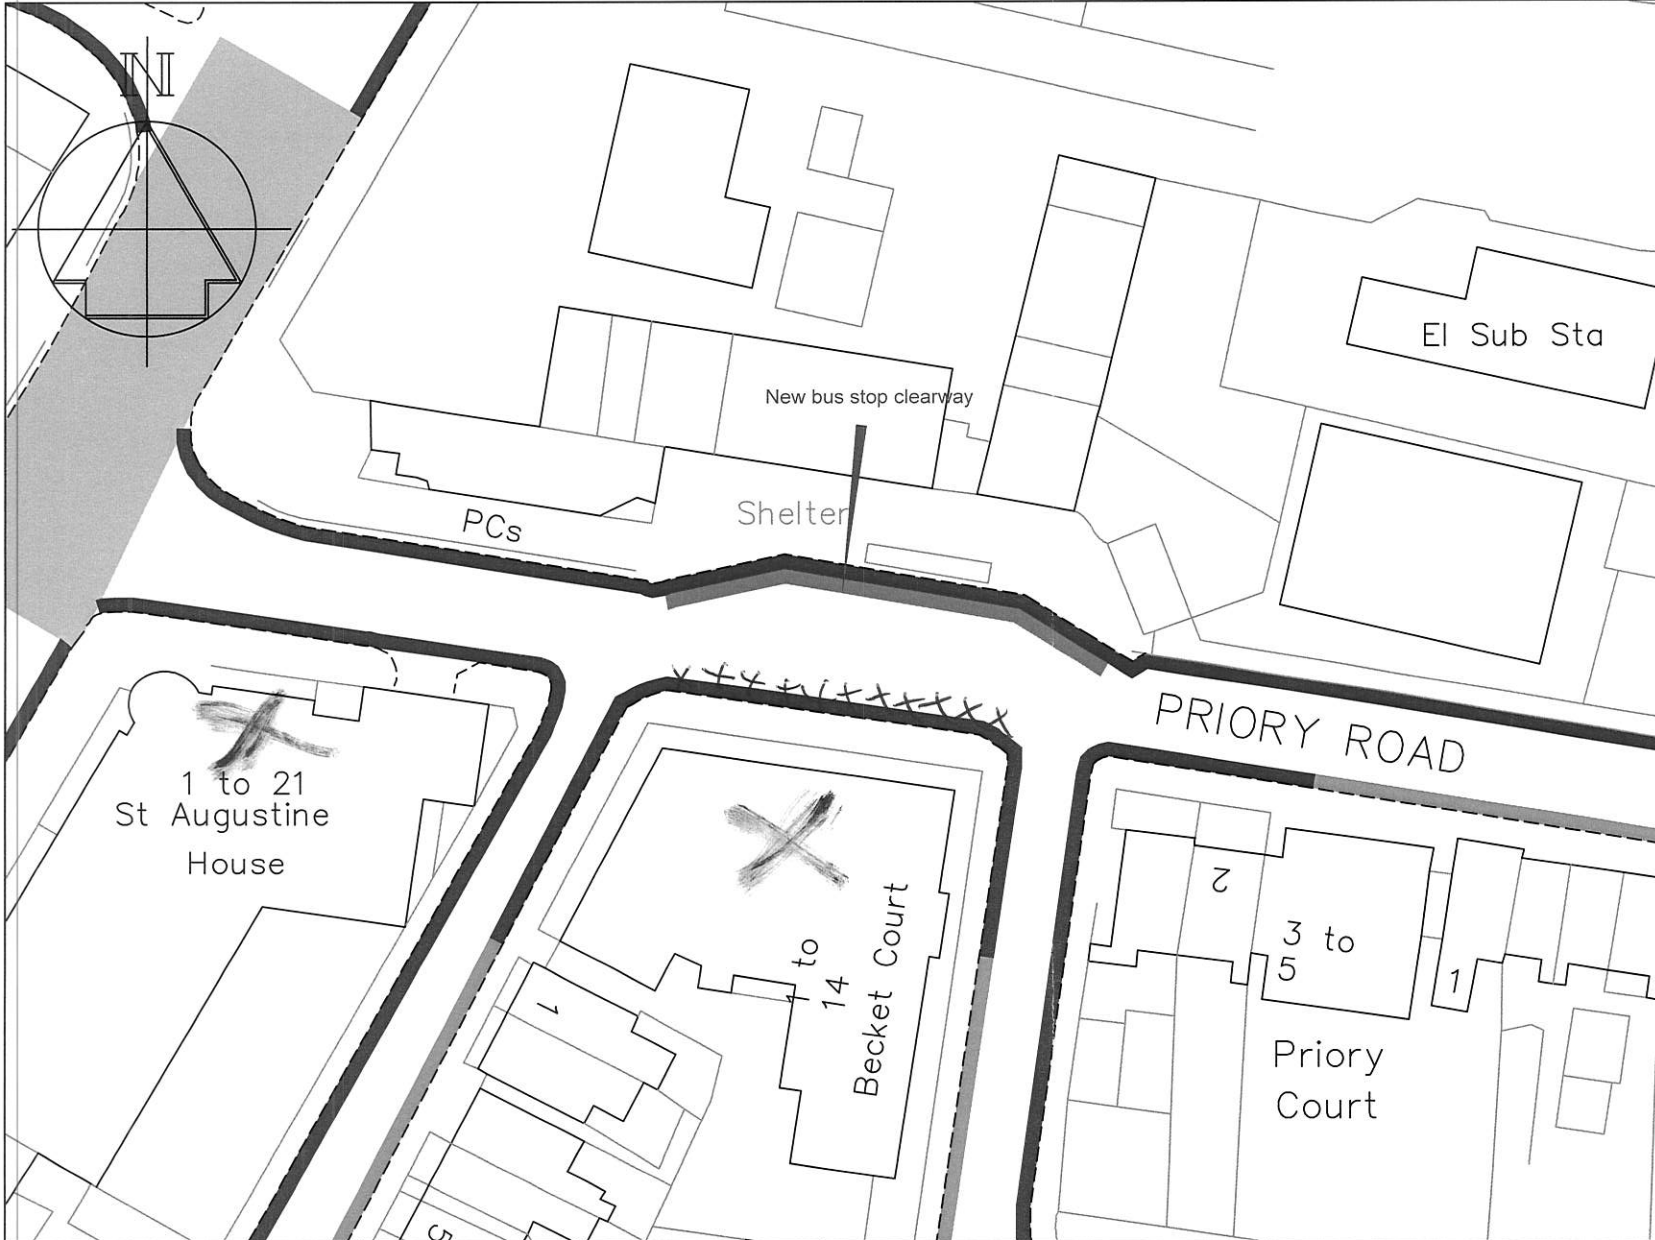

Key

— Existing "No waiting at any time" (double yellow lines)

— Proposed bus stop clearway

-	-
Revision	Date



STREETSCENE,
LEISURE &
TECHNICAL SERVICES

Transportation Team
Gibson Building
Gibson Drive
Kings Hill
West Malling
Kent ME19 4LZ
Tel: 01732 844522 Fax: 01732 876317

Project Title
Parking Action Plan - Phase 13
Informal consultation

Drawing Title
Tonbridge
Priory Road

Drawn ACB	Checked AE	Date 12/2021
--------------	---------------	-----------------

Scale 1 : 500 @ A4

Drawing No. DD/591/21	Rev -
--------------------------	----------

**Informal Consultation
New & Amended Parking Restrictions
Priory Road, Tonbridge**

Please return this form to;

The Parking Team
Tonbridge & Malling Borough Council
Gibson Building, Gibson Drive
Kings Hill
West Malling
Kent ME19 4LZ

Alternatively, responses can be sent via email to parking.office@tmbc.gov.uk, quoting reference DD/591/21 Priory Road

Want to go digital? You can view the proposals and respond online by visiting www.tmbc.gov.uk/parkingphases or scanning this QR code



All responses must be received by 30th January 2022.

Data protection

Please remember that any comments made may be used within reports to Councillors and within documents that may be made available to the public, though any personal information will be protected.

If you would like more information about how we use your data, please read our Privacy Statement on our website www.tmbc.gov.uk/parking

Name (please print)		
Address		
Telephone		
Email		

I am (~~in favour~~ / **not in favour**)* of the Borough Council's proposals for changes to the on-street parking arrangements for Priory Road, , shown on plan DD/591/21

* *delete where not applicable*

Comments	
<p>I am NOT in Favour of this BUT IF IT goes ahead then I support the proposals one thing I like you to do which I really get Fed up with & lots more do is to Tell all these Bus drives to turn off the Engine when there Park we do get Fed up with it I hope you can do something about that Thank you</p>	
Signed	Date 17. 1. 22

From: [REDACTED]
To: [Parking Office](#)
Subject: [SUSPICIOUS MESSAGE] DD/591/21 Priory Road
Date: 25 January 2022 16:41:03

I am not in favour of the proposal of Bus Parking opposite Becket Court, Alexandra Road. St Augustine House has the same problem as we do. The air quality and dirt is bad enough without adding more. These two buildings have a lot of sick residents and you will make it worse. parking is a huge problem at the moment.

Yours Sincerely

[REDACTED]

This email has been scanned by TMBC before delivery to your mailbox. Please click [here](#) to report this email as spam and help train the filter.